

No work is to be done before this matter is finalized and a "Change Order" is issued. This copy to remain with your office. Do not return. Contractor to submit signed letter with price including cost breakdown and change (if any) to construction schedule. Authority having Jurisdiction shall advise of any objections.

TO: QUOREX CONSTRUCTION SERVICES LTD.

1630A 8th Avenue,
Regina, SK S4R 1E5

RE: AURORA FOOD STORE

2000 ANAQUOD ROAD
REGINA, SK
Commission No. 2445

DATE: November 27, 2025

PAGES: 4 (including cover)

RE: Frozen Foods Refrigeration Defrost Heaters

1.0 ELECTRICAL

- .1 Refer to attached Electrical PCN #28, dated November 26, 2025 (3 pages).
- .2 Modifications as per LMP's second version of Refrigeration drawing R01 (2025-02-04, not 2024-11-19):

CRN REQUIRED		NO
RBQ REQUIRED		NO
TSSA REQUIRED		NO

Voltage	Amp	Voltage
120V / 1Ø	9.56	208V / 1Ø
120V / 1Ø	23.95	208V / 1Ø
-	23.95	208V / 1Ø
120V / 1Ø	9.56	208V / 1Ø
120V / 1Ø	16.82	208V / 1Ø
120V / 1Ø	13.46	208V / 1Ø
120V / 1Ø	9.56	208V / 1Ø
120V / 1Ø	16.07	208V / 1Ø
-	16.07	208V / 1Ø
120V / 1Ø	9.56	208V / 1Ø
120V / 1Ø	9.56	208V / 1Ø
120V / 1Ø	16.07	208V / 1Ø
-	16.07	208V / 1Ø
120V / 1Ø	9.56	208V / 1Ø
-	15.5	208V / 1Ø
-	11.9	208V / 1Ø
-	11.9	208V / 1Ø
120V / 1Ø	9.56	208V / 1Ø
120V / 1Ø	16.07	208V / 1Ø
-	16.07	208V / 1Ø
120V / 1Ø	9.56	208V / 1Ø
120V / 1Ø	9.56	208V / 1Ø
120V / 1Ø	16.07	208V / 1Ø
-	16.07	208V / 1Ø
120V / 1Ø	9.56	208V / 1Ø
120V / 1Ø	9.56	208V / 1Ø
120V / 1Ø	16.07	208V / 1Ø
-	16.07	208V / 1Ø
120V / 1Ø	9.56	208V / 1Ø
120V / 1Ø	10.08	208V / 1Ø
120V / 1Ø	15.5	208V / 1Ø
120V / 1Ø	13.46	208V / 1Ø
120V / 1Ø	16.82	208V / 1Ø
120V / 1Ø	16.82	208V / 1Ø

NO.	DATE
00	2024-10-16
01	2025-02-04
02	
03	



**EVAPCO SYSTEMS
LMP**

MANUFACTURER OF MODULAR SYSTEMS

970, PLACE PAUL-KANE
LAVAL, QC H7C 2T2
TEL: 450 629 9864
design@evapcolmp.ca

NOTE :

THE COPYRIGHT TO ALL
DESIGN AND DRAWINGS
ARE THE PROPERTY OF
LMP SYSTEMS.
REPRODUCTION OR USE
FOR ANY PURPOSE OTHER
THAN THAT AUTHORIZED
BY LMP SYSTEMS.

Distribution:

Sobeys Inc. – Jeff Craig
Sobeys Inc. – Shanwen Hsu
Quorex Construction Services Ltd. – Chris Walbaum
Quorex Construction Services Ltd. – Dustin Williamson
Lavergne Draward & Associates Inc. – Charles Koop
CGM Engineering – Justin Albo
CGM Engineering – Tony Mitousis
CGM Engineering – Brendan Simpson



Principal
Kevin Fawley, SAA MRAIC

jeff.craig@sobeys.com
shanwen.hsu@sobeys.com
c.walbaum@quorex.ca
d.williamson@quorex.ca
ckoop@ldaeng.ca
justin_albo@cgmeng.ca
tony_mitousis@cgmeng.ca
brendan_simpson@cgmeng.ca

Project: Aurora Grocery Store
2000 Anaquod Road, Regina, Saskatchewan
Subject: Refrigeration Equipment Phase Change – Defrost Heaters
Date: 2025.11.26

Subject: Refrigeration Equipment Phase Change – Defrost Heaters
References: Electrical Drawing E0.3 – Schedules
Electrical Drawing E2.0 – Refrigeration

1. Refer to attached drawing E0.3 - Schedules for revisions in Panel 'R1M', Panel 'R2L', Panel 'R3L' and Panel 'R4L'.
 - 1.1. Total of five(5) 15A-3P breakers, five(5) 20A-3P breakers and fourteen(14) 25A-3P breakers are removed.
 - 1.2. Total of five(5) 15A-2P breakers, five(5) 20A-3P breakers and fourteen(14) 25A-2P breakers are added.
2. Refer to attached drawing E4.0 – Refrigeration for revised circuitry for equipment defrost heaters. Refer to LMP refrigeration schedule for details.


PANEL '2B'				
200A-120/208V-3PH-4W PANEL SURFACE MOUNTED IN WEST STAFF CORRIDOR				
DESCRIPTION	CIRCUIT BREAKER	PHASE A B C	CIRCUIT BREAKER	DESCRIPTION
DWH-1, DOMESTIC WATER HEATER	15	1 0 2	-	SPACE
DWH-2, DOMESTIC WATER HEATER	15	3 0 4	15	EF-5, EXHAUST FAN
P-1, RE-CIRCULATION PUMP	15	5 0 6	15	EF-6, EXHAUST FAN
P-2, RE-CIRCULATION PUMP	15	7 0 8	15	EF-5, EXHAUST FAN
CU-1, CONDENSING UNIT	20	9 0 10	15	EF-6, EXHAUST FAN
	11	1 12	15	EF-7, EXHAUST FAN
	13	0 14	15	EF-5, EXHAUST FAN
MUA-1, MAKE-UP AIR	20	15 0 16	15	DF-2.4-8, DESTRATIFICATION FAN
	17	0 18	15	DF-3.5-7, DESTRATIFICATION FAN
	19	0 20	15	DF-3.8, DESTRATIFICATION FAN
	21	0 22	15	TF-3, TRANSFER FAN
EF-6, EXHAUST FAN #10 WIRE	30	21 0 22	15	UH-1, UNIT HEATER
	23	0 24	15	UH-1, UNIT HEATER
ERV-1, ENERGY RECOVERY VENTILATOR	15	25 0 26	15	UH-3, UNIT HEATER
EHC-1, ELECTRIC HEATING COIL #8 WIRE	27	0 28	15	UH-3, UNIT HEATER
	29	0 30	15	UH-4, UNIT HEATER
EHC-2, ELECTRIC HEATING COIL #8 WIRE	35	31 0 32	15	UH-5, UNIT HEATER
	33	0 34	15	MOTORIZED DAMPERS
SPACE	-	35	0 36	-
EFF-1, FORCE FLOW HEATER (1 x 2.0 kW)	15	37 0 38	-	SPACE
	39	0 40	-	SPACE
EFF-1, FORCE FLOW HEATER (1 x 2.0 kW)	15	41 0 42	-	SPACE
	43	0 44	-	SPACE
EBB-1, BASEBOARD HEATERS (4 x 1.0 kW) #10 WIRE	25	45 0 46	-	SPACE
SPACE	-	47	0 48	SPACE
SPACE	-	49	0 50	SPACE
SPACE	-	51	0 52	SPACE
SPACE	-	53	0 54	SPACE
SPACE	-	55	0 56	SPACE
SPACE	-	57	0 58	SPACE
SPACE	-	59	0 60	SPACE
SPACE	-	61	0 62	SPACE
SPACE	-	63	0 64	SPACE
SPACE	-	65	0 66	SPACE
SPACE	-	67	0 68	SPACE
SPACE	-	69	0 70	SPACE
SPACE	-	71	0 72	SPACE
SPACE	-	73	0 74	SPACE
SPACE	-	75	0 76	SPACE
SPACE	-	77	0 78	SPACE
SPACE	-	79	0 80	SPACE
SPACE	-	81	0 82	SPACE
SPACE	-	83	0 84	SPACE

PANEL 'C1'				
100A-120/208V-3PH-4W PANEL SURFACE MOUNTED IN COMPRESSOR ROOM 300				
DESCRIPTION	CIRCUIT BREAKER	PHASE A B C	CIRCUIT BREAKER	DESCRIPTION
FIRE ALARM CONTROL PANEL	15	1 0 2	-	SPACE
TELECOM BACKBOARD	20	3 0 4	20	DOCK LEVELER
SECURITY PANEL	20	5 0 6	-	SPACE
DATA RACK	20	7 0 8	-	SPACE
SPACE	20	9 0 10	20	DOCK LEVELER
SPACE	20	11 0 12	-	SPACE
SPACE	20	13 0 14	15	OVERHEAD DOOR
SPACE	15	15 0 16	15	OVERHEAD DOOR
SPACE	15	17 0 18	15	SC RECEPTACLE
ROOF MAINTENANCE RECEPTACLE	20	19 0 20	15	SC RECEPTACLE
ROOF MAINTENANCE RECEPTACLE	20	21 0 22	15	HOUSEKEEPING RECEPTABLES
ROOF MAINTENANCE RECEPTACLE	20	23 0 24	15	SPACE
ROOF MAINTENANCE RECEPTACLE	20	25 0 26	15	SPACE
ROOF MAINTENANCE RECEPTACLE	20	27 0 28	15	HOUSEKEEPING RECEPTACLE
ROOF MAINTENANCE RECEPTACLE	20	29 0 30	-	SPACE
ROOF MAINTENANCE RECEPTACLE	20	31 0 32	-	SPACE
ROOF MAINTENANCE RECEPTACLE	20	33 0 34	-	SPACE
ROOF MAINTENANCE RECEPTACLE	20	35 0 36	-	SPACE
ROOF MAINTENANCE RECEPTACLE	20	37 0 38	-	SPACE
ROOF MAINTENANCE RECEPTACLE	20	39 0 40	-	SPACE
SPACE	-	41 0 42	-	SPACE
SPACE	-	43 0 44	-	SPACE
SPACE	-	45	0 46	SPACE
SPACE	-	47 0 48	-	SPACE
SPACE	-	49 0 50	-	SPACE
SPACE	-	51 0 52	-	SPACE
SPACE	-	53 0 54	-	SPACE
SPACE	-	55 0 56	-	SPACE
SPACE	-	57 0 58	-	SPACE
SPACE	-	59 0 60	-	SPACE
SPACE	-	61 0 62	-	SPACE
SPACE	-	63 0 64	-	SPACE
SPACE	-	65 0 66	-	SPACE
SPACE	-	67 0 68	-	SPACE
SPACE	-	69 0 70	-	SPACE
SPACE	-	71 0 72	-	SPACE
SPACE	-	73 0 74	-	SPACE
SPACE	-	75 0 76	-	SPACE
SPACE	-	77 0 78	-	SPACE
SPACE	-	79 0 80	-	SPACE
SPACE	-	81 0 82	-	SPACE
SPACE	-	83 0 84	-	SPACE

PANEL 'R1M'				
200A-120/208V-3PH-4W PANEL SURFACE MOUNTED IN WEST STAFF CORRIDOR				
DESCRIPTION	CIRCUIT BREAKER	PHASE A B C	CIRCUIT BREAKER	DESCRIPTION
AM-C1 (LIGHTS, FANS, ANTI-CONDENSATE)	15	1 0 2	15	AM-C27 (LIGHTS, FANS, ANTI-CONDENSATE)
AM-C2 (LIGHTS, FANS, ANTI-CONDENSATE)	15	3 0 4	15	AM-C28 (LIGHTS, FANS, ANTI-CONDENSATE)
AM-C3 (LIGHTS, FANS, ANTI-CONDENSATE)	15	5 0 6	15	AM-C29 (LIGHTS, FANS, ANTI-CONDENSATE)
AM-C4 (LIGHTS, FANS, ANTI-CONDENSATE)	15	7 0 8	15	AM-C30 (LIGHTS, FANS, ANTI-CONDENSATE)
AM-C5 (LIGHTS, FANS, ANTI-CONDENSATE)	15	9 0 10	15	AM-C31 (LIGHTS, FANS, ANTI-CONDENSATE)
AM-C6 (LIGHTS, FANS, ANTI-CONDENSATE)	15	11 0 12	15	AM-C32 (LIGHTS, FANS, ANTI-CONDENSATE)
AM-C7 (LIGHTS, FANS, ANTI-CONDENSATE)	15	13 0 14	15	AM-C33 (LIGHTS, FANS, ANTI-CONDENSATE)
AM-C8 (LIGHTS, FANS, ANTI-CONDENSATE)	15	15 0 16	15	AM-C34 (LIGHTS, FANS, ANTI-CONDENSATE)
AM-C9 (LIGHTS, FANS, ANTI-CONDENSATE)	15	17 0 18	15	AM-C35 (LIGHTS, FANS, ANTI-CONDENSATE)
AM-C10 (LIGHTS, FANS, ANTI-CONDENSATE)	15	19 0 20	15	AM-C36 (LIGHTS, FANS, ANTI-CONDENSATE)
AM-C11 (LIGHTS, FANS, ANTI-CONDENSATE)	15	21 0 22	15	AM-E8 (EVAPORATOR PANEL I)
AM-C12 (LIGHTS, FANS, ANTI-CONDENSATE)	15	23 0 24	-	SPACE
SPACE	-	25 0 26	15	AM-C37 (LIGHTS, FANS, ANTI-CONDENSATE)
SPACE	-	27 0 28	15	AM-C38 (LIGHTS, FANS, ANTI-CONDENSATE)
AM-C13 (LIGHTS, FANS, ANTI-CONDENSATE)	15	29 0 30	15	AM-C39 (LIGHTS, FANS, ANTI-CONDENSATE)
AM-C14 (LIGHTS, FANS, ANTI-CONDENSATE)	15	31 0 32	15	AM-C40 (LIGHTS, FANS, ANTI-CONDENSATE)
AM-E2 (EVAPORATOR PANEL E)	15	33 0 34	15	AM-C41 (LIGHTS, FANS, ANTI-CONDENSATE)
AM-C15 (LIGHTS, FANS, ANTI-CONDENSATE)	15	35 0 36	15	AM-C42 (LIGHTS, FANS, ANTI-CONDENSATE)
AM-C16 (LIGHTS, FANS, ANTI-CONDENSATE)	15	37 0 38	15	AM-C43 (LIGHTS, FANS, ANTI-CONDENSATE)
AM-C17 (LIGHTS, FANS, ANTI-CONDENSATE)	15	39 0 40	15	AM-C44 (LIGHTS, FANS, ANTI-CONDENSATE)
AM-C18 (LIGHTS, FANS, ANTI-CONDENSATE)	15	41 0 42	15	AM-C45 (LIGHTS, FANS, ANTI-CONDENSATE)
AM-C19 (LIGHTS, FANS, ANTI-CONDENSATE)	15	43 0 44	15	AM-C46 (LIGHTS, FANS, ANTI-CONDENSATE)
AM-C20 (LIGHTS, FANS, ANTI-CONDENSATE)	15	45 0 46	15	AM-C47 (LIGHTS, FANS, ANTI-CONDENSATE)
AM-C21 (LIGHTS, FANS, ANTI-CONDENSATE)	15	47 0 48	15	AM-C48 (LIGHTS, FANS, ANTI-CONDENSATE)
AM-C22 (LIGHTS, FANS, ANTI-CONDENSATE)	15	49 0 50	15	AM-C49 (LIGHTS, FANS, ANTI-CONDENSATE)
AM-C23 (LIGHTS, FANS, ANTI-CONDENSATE)	15	51 0 52	15	AM-C50 (LIGHTS, FANS, ANTI-CONDENSATE)
AM-E3 (EVAPORATOR PANEL F)	15	53 0 54	15	AM-C51 (LIGHTS, FANS, ANTI-CONDENSATE)
AM-E4 (EVAPORATOR PANEL G)	25	55 0 56	15	AM-C52 (LIGHTS, FANS, ANTI-CONDENSATE)
AM-C53 (LIGHTS, FANS)	15	58 0 60	15	AM-E11 (EVAPORATOR PANEL K)
AM-C54 (LIGHTS, FANS)	15	61 0 62	15	AM-E12 (EVAPORATOR PANEL L)
AM-E6 (EVAPORATOR PANEL M)	15	63 0 64	15	AM-E13 (EVAPORATOR PANEL N)
SPACE	-	65 0 66	15	AM-E14 (EVAPORATOR PANEL N)
AM-C24 (LIGHTS, FANS, ANTI-CONDENSATE)	15	67 0 68	15	-
AM-C25 (LIGHTS, FANS, ANTI-CONDENSATE)	15	69 0 70	-	SPACE
AM-C26 (LIGHTS, FANS, ANTI-CONDENSATE)	15	71 0 72	-	SPACE
SPACE	-	73 0 74	-	SPACE
SPACE	-	75 0 76	-	SPACE
SPACE	-	77 0 78	-	SPACE
SPACE	-	79 0 80	-	SPACE
SPACE	-	81 0 82	-	AM-C17 (DEFROST HEATERS)
SPACE	-	83 0 84	-	AM-C18 (DEFROST HEATERS)
SPACE	-	85 0 86	-	SPACE
SPACE	-	87 0 88	-	AM-C19 (DEFROST HEATERS)
SPACE	-	89 0 90	-	SPACE
SPACE	-	91 0 92	-	AM-C20 (DEFROST HEATERS)
SPACE	-	93 0 94	-	SPACE
SPACE	-	95 0 96	-	AM-C21 (DEFROST HEATERS)
SPACE	-	97 0 98	-	SPACE
SPACE	-	99 0 100	-	AM-C22 (DEFROST HEATERS)
SPACE	-	101 0 102	-	SPACE
SPACE	-	103 0 104	-	AM-C23 (DEFROST HEATERS)
SPACE	-	105 0 106	-	SPACE
SPACE	-	107 0 108	-	SPACE
SPACE	-	109 0 110	-	SPACE
SPACE	-	111 0 112	-	SPACE
SPACE	-	113 0 114	-	SPACE
SPACE	-	115 0 116	-	SPACE
SPACE	-	117 0 118	-	SPACE
SPACE	-	119 0 120	-	SPACE

PANEL 'C2'				
200A-120/208V-3PH-4W PANEL RECESS MOUNTED IN OFFICE CORRIDOR				
DESCRIPTION	CIRCUIT BREAKER	PHASE A B C	CIRCUIT BREAKER	DESCRIPTION
CHECKOUT #1	15	1 0 2	15	SELF CHECKOUT #1
CHECKOUT #1	15	3 0 4	15	SELF CHECKOUT #1
CHECKOUT #2	15	5 0 6	15	SELF CHECKOUT #2
CHECKOUT #2	15	7 0 8	15	SELF CHECKOUT #2
CHECKOUT #3	15	9 0 10	15	SELF CHECKOUT #3
CHECKOUT #3	15	11 0 12	15	SELF CHECKOUT #3
CHECKOUT #4	15	13 0 14	15	SELF CHECKOUT #4
CHECKOUT #4	15	15 0 16	15	SELF CHECKOUT #4
CHECKOUT #5	15	17 0 18	15	SELF CHECKOUT #5
CHECKOUT #5	15	19 0 20	15	SELF CHECKOUT #5
CHECKOUT #6	15	21 0 22	15	SELF CHECKOUT #6
CHECKOUT #6	15	23 0 24	15	SELF CHECKOUT #6
CHECKOUT COOLER	15	25 0 26	15	SERVICE DESK
SPACE	-	27 0 28	15	SERVICE DESK
SPACE	-	29 0 30	15	SERVICE DESK
EXTERIOR SIGNAGE	15	31 0 32	15	SERVICE DESK
ICE COOLER	15	33 0 34	15	SERVICE DESK
EXTERIOR SEATING RECEPTABLES	15	35 0 36	15	BILLBOARD - CHECKOUT
COUNTER RECEPTABLES	20	37 0 38	15	BILLBOARD - CHECKOUT
COUNTER RECEPTABLES	20	39 0 40	15	BILLBOARD - CHECKOUT
COUNTER RECEPTABLES	20	41 0 42	15	BILLBOARD - CHECKOUT
ROLLER WINDOW SHUTTER	15	43 0 44	15	EBB-1, BASEBOARD HEATER (1 x 2.0 kW)
ROLLER WINDOW SHUTTER	15	45 0 46	15	SPACE
ROLLER WINDOW SHUTTER	15	47 0 48	15	SPACE
ROLLER WINDOW SHUTTER	15	49 0 50	15	SPACE
EXTERIOR SIGNAGE	15	51 0 52	15	CHECKOUT COOLER
WATER DISPENSER	15	53 0 54	15	SPACE
CONSTAIR	15	55 0 56	15	SPACE
ATM	15	57 0 58	15	CHECKOUT COOLER
VESTIBULE TV	15	59 0 60	15	SPACE
SPACE	-	61 0 62	15	SPACE
SPACE	-	63 0 64	15	SPACE
SPACE	-	65 0 66	-	SPACE
SPACE	-	67 0 68	-	SPACE
SPACE	-	69 0 70	-	SPACE
SPACE	-	71 0 72	-	SPACE
SPACE	-	73 0 74	-	SPACE
SPACE	-	75 0 76	-	SPACE
SPACE	-	77 0 78	-	SPACE
SPACE	-	79 0 80	-	SPACE
SPACE	-	81 0 82	-	SPACE
SPACE	-	83 0 84	-	SPACE

PANEL 'R1L'				
200A-120/208V-3PH-4W PANEL SURFACE MOUNTED IN WEST STAFF CORRIDOR				
DESCRIPTION	CIRCUIT BREAKER	PHASE A B C	CIRCUIT BREAKER	DESCRIPTION
AL-C1 (FANS, LIGHTS, ANTI-CONDENSATE)	15	1 0 2	-	SPACE
AL-C2 (FANS, LIGHTS, ANTI-CONDENSATE)	15	3 0 4	-	SPACE
AL-C4 (FANS, LIGHTS, ANTI-CONDENSATE)	15	5 0 6	15	AL-C26 (FANS, LIGHTS, ANTI-CONDENSATE)
AL-C5 (FANS, LIGHTS, ANTI-CONDENSATE)	15	7 0 8	15	AL-C29 (FANS, LIGHTS, ANTI-CONDENSATE)
AL-C6 (FANS, LIGHTS, ANTI-CONDENSATE)	15	9 0 10	15	AL-C30 (FANS, LIGHTS, ANTI-CONDENSATE)
AL-C7 (FANS, LIGHTS, ANTI-CONDENSATE)	15	11 0 12	15	AL-C31 (FANS, LIGHTS, ANTI-CONDENSATE)
AL-C8 (FANS, LIGHTS, ANTI-CONDENSATE)	15	13 0 14	15	AL-C32 (FANS, LIGHTS, ANTI-CONDENSATE)
AL-C9 (FANS, LIGHTS, ANTI-CONDENSATE)	15	15 0 16	15	AL-C33 (FANS, LIGHTS, ANTI-CONDENSATE)
AL-C10 (FANS, LIGHTS, ANTI-CONDENSATE)	15	17 0 18	15	AL-C34 (FANS, LIGHTS, ANTI-CONDENSATE)
AL-C11 (FANS, LIGHTS, ANTI-CONDENSATE)	15	19 0 20	15	AL-C35 (FANS, LIGHTS, ANTI-CONDENSATE)
AL-C12 (FANS, LIGHTS, ANTI-CONDENSATE)	15	21 0 22	15	AL-C36 (FANS, LIGHTS, ANTI-CONDENSATE)
AL-C13 (FANS, LIGHTS, ANTI-CONDENSATE)	15	23 0 24	15	AL-C37 (FANS, LIGHTS, ANTI-CONDENSATE)
AL-C14 (FANS, LIGHTS, ANTI-CONDENSATE)	15	25 0 26	15	AL-C38 (FANS, LIGHTS, ANTI-CONDENSATE)
SPACE	-	27 0 28	15	AL-C39 (FANS, LIGHTS, ANTI-CONDENSATE)
SPACE	-	29 0 30	15	AL-C40 (FANS, LIGHTS, ANTI-CONDENSATE)
AL-C27 (FANS, LIGHTS, ANTI-CONDENSATE)	15	53 0 54	-	SPACE
SPACE	-	55 0 56	-	SPACE

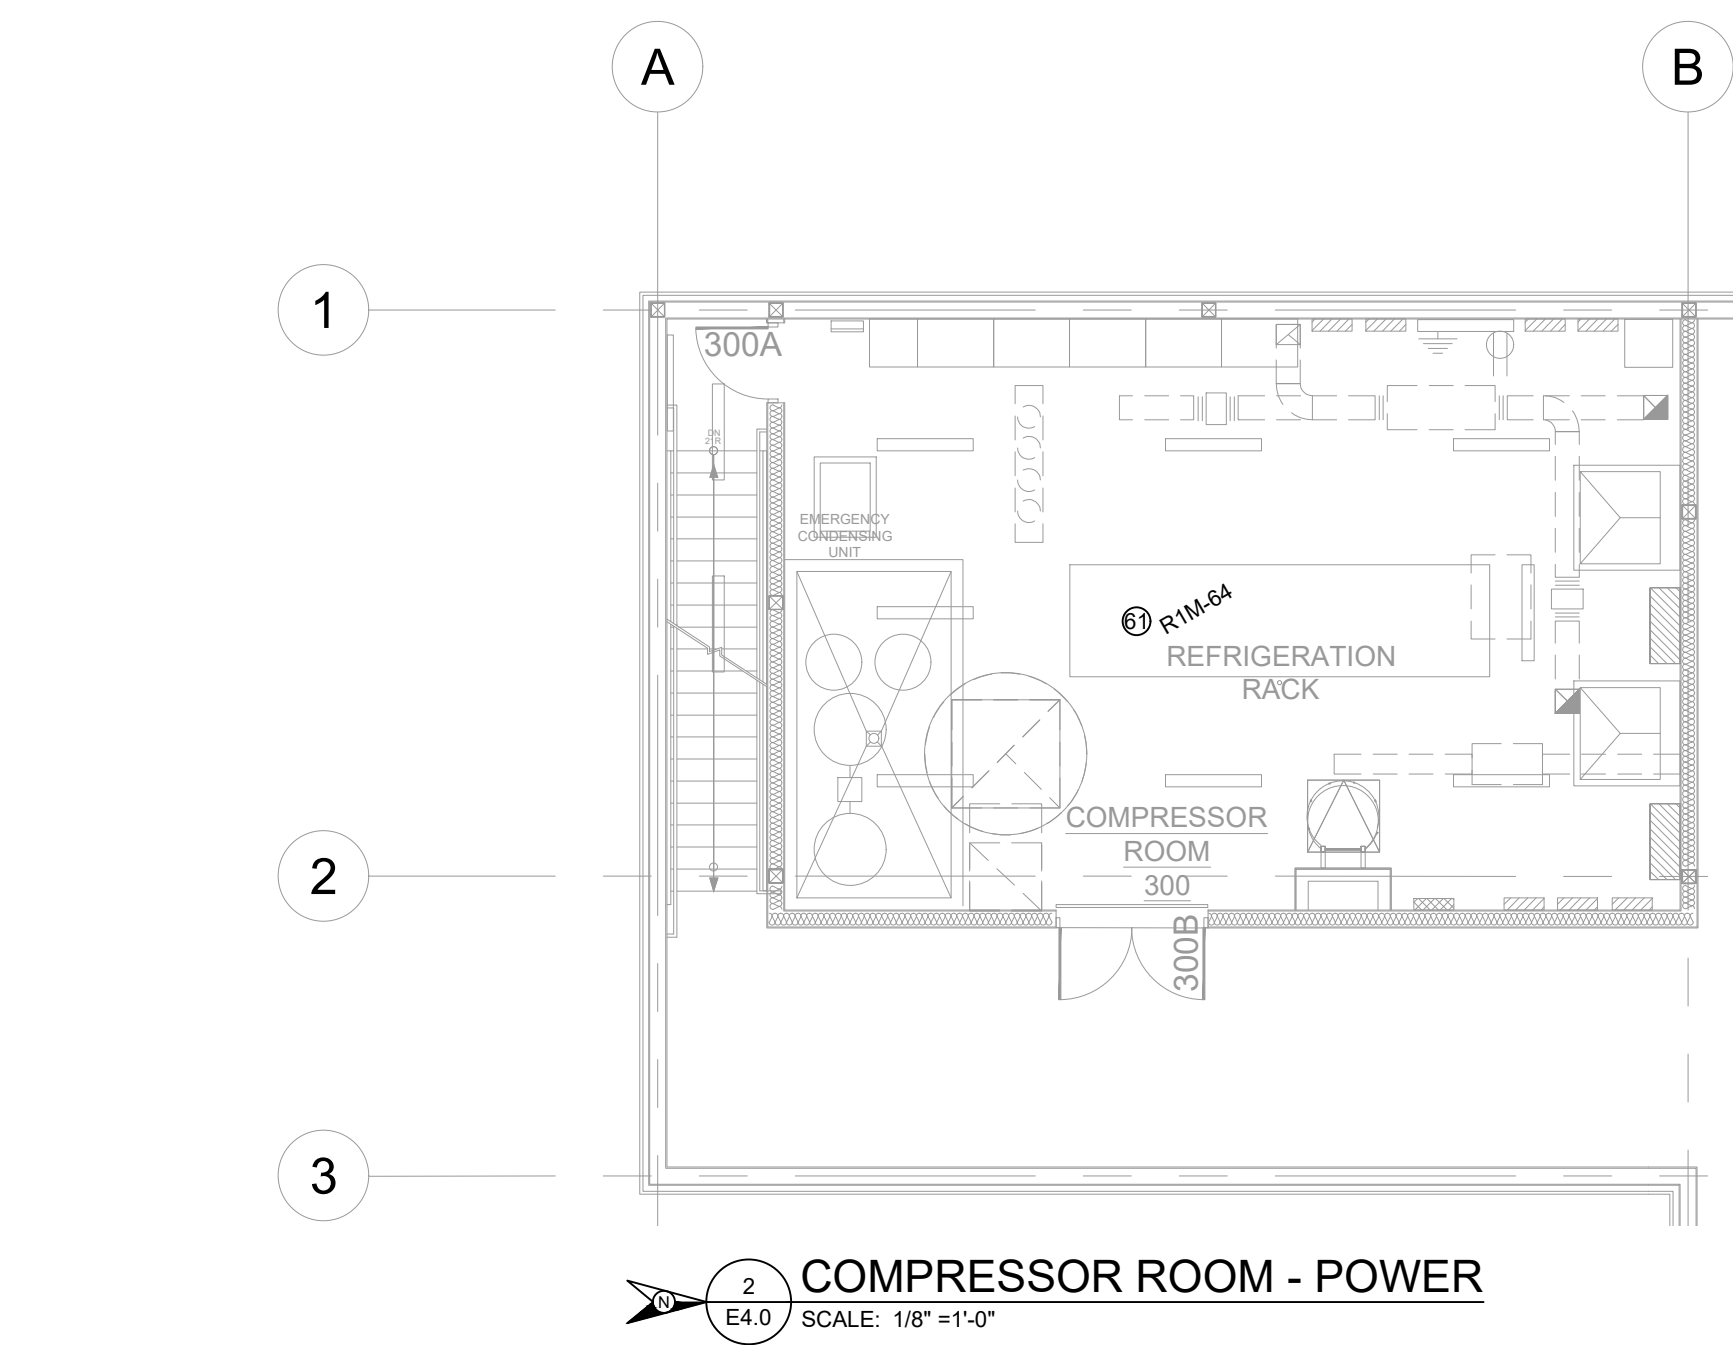

- GENERAL NOTES**
- ELECTRICAL CONTRACTOR SHALL ENSURE THAT ALL WORK REQUIRED FOR THE REFRIGERATION SYSTEM IS COMPLETED AS PER SCHEDULE PRIOR TO STORE OPENING.
 - THE ELECTRICAL CONTRACTOR SHALL COORDINATE WITH THE REFRIGERATION CONTRACTOR, EQUIPMENT SUPPLIER AND THE OWNER'S REPRESENTATIVE IN ALL ASPECTS OF THE REFRIGERATION WORKS. PROVIDE ALL REQUIRED POWER AND CONTROL WIRING INCLUDING FINAL POWER CONNECTION TO ALL EQUIPMENT, CASES, CASE CONTROLLER ETC.
 - ELECTRICAL JUNCTION BOXES FOR WALK-IN COOLERS AND FREEZERS SHALL BE LOCATED ON TOP OF THE COOLER/FREEZER. COORDINATE FINAL LOCATION OF JUNCTION BOXES WITH COOLER/FREEZER SUPPLIER AND WITH THE REFRIGERATION CONTRACTOR.
 - REFER TO REFRIGERATION EQUIPMENT SCHEDULE FOR EQUIPMENT ELECTRICAL DATA.
 - ALL EXPOSED ELECTRICAL CONDUITS IN OPEN CEILING AREAS ARE TO BE MOUNTED AS CLOSE AS POSSIBLE TO THE UNDERSIDE OF THE ROOF DECK.
 - SEAL CONDUITS WHERE PASSING THROUGH FLOORS, EXTERIOR WALLS, CEILING, COOLERS, FREEZERS AND MEAT ROOM.
 - ALL REFRIGERATION CONDUITS AND WIRING INSTALLATIONS SHALL COMPLY WITH CANADIAN ELECTRICAL CODE, ALL OTHER APPLICABLE CODES, STANDARDS AND REGULATIONS.
 - ELECTRICAL CONTRACTOR TO PROVIDE PROPER IDENTIFICATIONS TO EACH END OF WIRES, CABLES AND CONDUITS TO SUIT EACH CORRESPONDING SYSTEM.
 - THE ELECTRICAL CONTRACTOR TO DETERMINE THE APPROPRIATE ROUTING AND METHOD OF ELECTRICAL DISTRIBUTION TO THE EQUIPMENT BY VERIFYING THE EXACT SUITABLE LOCATION OF ALL SUB-UPS, JUNCTION BOXES OR DROP DOWN CORDS (WHICH IS APPLICABLE) IN COORDINATION WITH THE OWNER'S REPRESENTATIVE AND/OR REFRIGERATION CONTRACTOR PRIOR TO ROUGH-IN.
 - EACH REFRIGERATION EQUIPMENT SHALL BE PIPED AND WIRED TO THEIR RESPECTIVE CONTROL AND POWER PANEL. COORDINATE WITH REFRIGERATION CONTRACTOR FOR OTHER CIRCUIT AND WIRING REQUIREMENTS.
 - NO ELECTRICAL INSTALLATIONS (CONDUIT, WIRING, ETC.) ARE ALLOWED ON COOLER/FREEZER PANEL UNLESS OTHERWISE APPROVED BY THE ENGINEER OR SOBEYS MANAGER.
 - REFRIGERATION TRADE TO COORDINATE WITH MECHANICAL TO MAXIMIZE THE EFFICIENCY OF REFRIGERATION PIPE RUNS MINIMIZING UNDERSLAB PLACEMENT WHERE POSSIBLE.
 - ALL ANTI-SWEAT CIRCUITS ARE TO BE C/W FIXED-TRIP 30mA GFCI PROTECTION.

6	PCN-28	2025.11.25	KC
5	PCN-27	2025.11.25	KC
4	PCN-26	2025.11.25	KC
3	PCN-25	2025.11.20	KC
2	PCN-24	2025.11.20	KC
1	PCN-21	2025.10.19	KC
NO. ISSUED FOR		DATE	BY
DRAWN BY:		BS	
PRINTING DATE: NOVEMBER 25, 2025			

DRAWING NOTES - REFRIGERATION

- PROVIDE CONNECTION TO REFRIGERATION COOLER/FREEZER BOX COILS. RUN CONDUIT ALONG CEILING AND DOWN TO JUNCTION BOX AT THE ROOF. COORDINATE WITH REFRIGERATION CONTRACTOR FOR FINAL JUNCTION BOX LOCATION. REFER TO REFRIGERATION SCHEDULE FOR CIRCUITING REQUIREMENTS. SIZE CONDUIT TO SUIT.
- REFRIGERATION CONTRACTOR TO FIELD INSTALL TEMPERATURE SENSORS, PRESSURE TRANSDUCERS, DOOR SWITCHES INCLUDING ALL OTHER LOOSE COMPONENTS FOR THE WALK-IN BOX/WALK-IN BOX COILS AS PER SAFETYWAY SPECIFICATIONS.
- PROVIDE SURFACE MOUNTED JUNCTION BOX FOR REFRIGERATION SYSTEMS AT 6'0" A.F.F. TO UNDERSIDE OF THE BOX AT THE WALL NEAREST TO THE SYSTEM ELECTRICAL FEED POINT. EXTEND POWER/CONTROL FEED DOWNWARD TO EACH CASE. CASE TO CASE CONTROLLER CONNECTIONS AND ALL OTHER FINAL TERMINATIONS SHALL ALSO BE BY THIS CONTRACTOR.
- PROVIDE INDIVIDUAL STUB-UPS FOR REACH-IN COOLERS AND CASES (SYSTEM WISE) IN LINE WITH THE COOLERS' ELECTRICAL WIRE WAY AND EXACTLY BENEATH THE TERMINAL BLOCK LOCATION. SIZE AND QUANTITY OF CONDUIT TO SUIT COOLERS POWER AND CONTROL REQUIREMENTS.
- POWER/CONTROL FEED TO REFRIGERATION EQUIPMENT (SYSTEM WISE) AT OPEN AREAS TO FOLLOW DROP/DOWN ROUTES OF REFRIGERANT PIPING THROUGH BOXED COLUMNS OR ALONG THE REFRIGERATION TRENCH (WHICHEVER IS APPLICABLE). COORDINATE WITH REFRIGERATION CONTRACTOR FOR FINAL REFRIGERANT PIPE ROUTING.
- PROVIDE STUB-UP FOR POWER/CONTROL FEED TO REFRIGERATION EQUIPMENT (SYSTEM WISE) AT FOOD PREPARATION AREA. ELECTRICAL CONDUITS TO BE ROUTED ALONG WITH THE REFRIGERANT PIPING IN THE REFRIGERATION TRENCH. COORDINATE WITH REFRIGERATION CONTRACTOR FOR FINAL REFRIGERANT PIPE ROUTING.
- FINAL REFRIGERATION SYSTEM NUMBER AND ARRANGEMENT TO BE DECIDED BY THE REFRIGERATION CONTRACTOR WITH ALL CHANGES FROM THE ORIGINAL DESIGN DRAWINGS TO BE REFLECTED ON THE RECORD DRAWINGS.
- PROVIDE 120V POWER FOR FREEZER DRAIN AND CONDENSATE LINE HEAT TRACE. WIRE AND CONNECT HEAT TRACE AS REQUIRED. HEAT TRACE CIRCUIT TO BE G.F.C.I. PROTECTED. CONFIRM EXACT REQUIREMENTS ON SITE. COORDINATE WITH REFRIGERATION CONTRACTOR.